

SORRENTO SAILING COUTA BOAT CLUB



— NEW EXTENSION

DRAWING LIST

TP-0001	PROJECT INFORMATION	B
TP-0002	LIQUOR LICENSE RED LINE PLAN	B
TP-0010	EXISTING SITE PLAN	B
TP-0011	EXISTING GROUND FLOOR PLAN	B
TP-0012	EXISTING FIRST FLOOR PLAN	B
TP-0013	EXISTING SECOND FLOOR & ROOF PLAN	B
TP-0015	DEMOLITION PLAN - GROUND	B
TP-0016	DEMOLITION PLAN - LEVEL 1	B
TP-0500	OVERALL SITE PLANS	B
TP-1000	PROPOSED SITE PLAN	B
TP-1001	PROPOSED GROUND FLOOR PLAN	B
TP-1002	PROPOSED FIRST FLOOR PLAN	B
TP-1003	PROPOSED SECOND FLOOR PLAN	B
TP-1004	ROOF PLAN	B
TP-2000	SECTION - SHEET 1	B
TP-2001	SECTION - SHEET 2	B
TP-2002	ELEVATION - SHEET 1	B
TP-2002B	MATERIALITY	B
TP-2003	ELEVATION - SHEET 2	B
TP-2003B	MATERIALITY	B
TP-8001	ENTRY PERSPECTIVE	A
TP-8002	NORTH WEST PERSPECTIVE	A
TP-8003	EAST FACADE PERSPECTIVE	A
TP-8004	DINING ROOM, FACING WEST DECK	A
TP-9010	AREAS	B

Builders / Contractors shall verify all dimensions before any work commences. Dimensions shown are nominal. Figured dimensions shall take precedence over scaled dimensions. Any discrepancies are to be made known to the Architects / Designers office prior to any works commencing on site. All shop drawings shall be submitted for review and manufacture shall not commence prior to the return of stamped shop drawings.
© Carr Interiors Pty Ltd
© Carr Architecture Pty Ltd

TOWN PLANNING

Rev	Date	Chkd	Issue
A	16.01.2019		For Town Planning
B	01.05.2020		S72 Amendment

Project SORRENTO SAILING COUTA BOAT CLUB

Project No 18014

3154 POINT NEAPEAN ROAD SORRENTO

Title PROJECT INFORMATION

Scale @A3 1 : 630

Date 04/11/18

Dwg No TP-0001


Drawn By JG, SM, TK

Chkd By SM

Rev B

Carr Interiors Pty Ltd
ABN 56 126 212 575
Carr Architecture Pty Ltd
ABN 47 099 953 205
Directors Sue Carr
Chris McCue ARBV AIA
Level 4 31 Flinders Lane
Melbourne VIC 3000 Australia
PO Box 18069
Collins Street East
Melbourne VIC 8003 Australia
Telephone 61 3 9665 2300
Facsimile 61 3 9650 5002
Email melb@carr.net.au
www.carr.net.au

carr

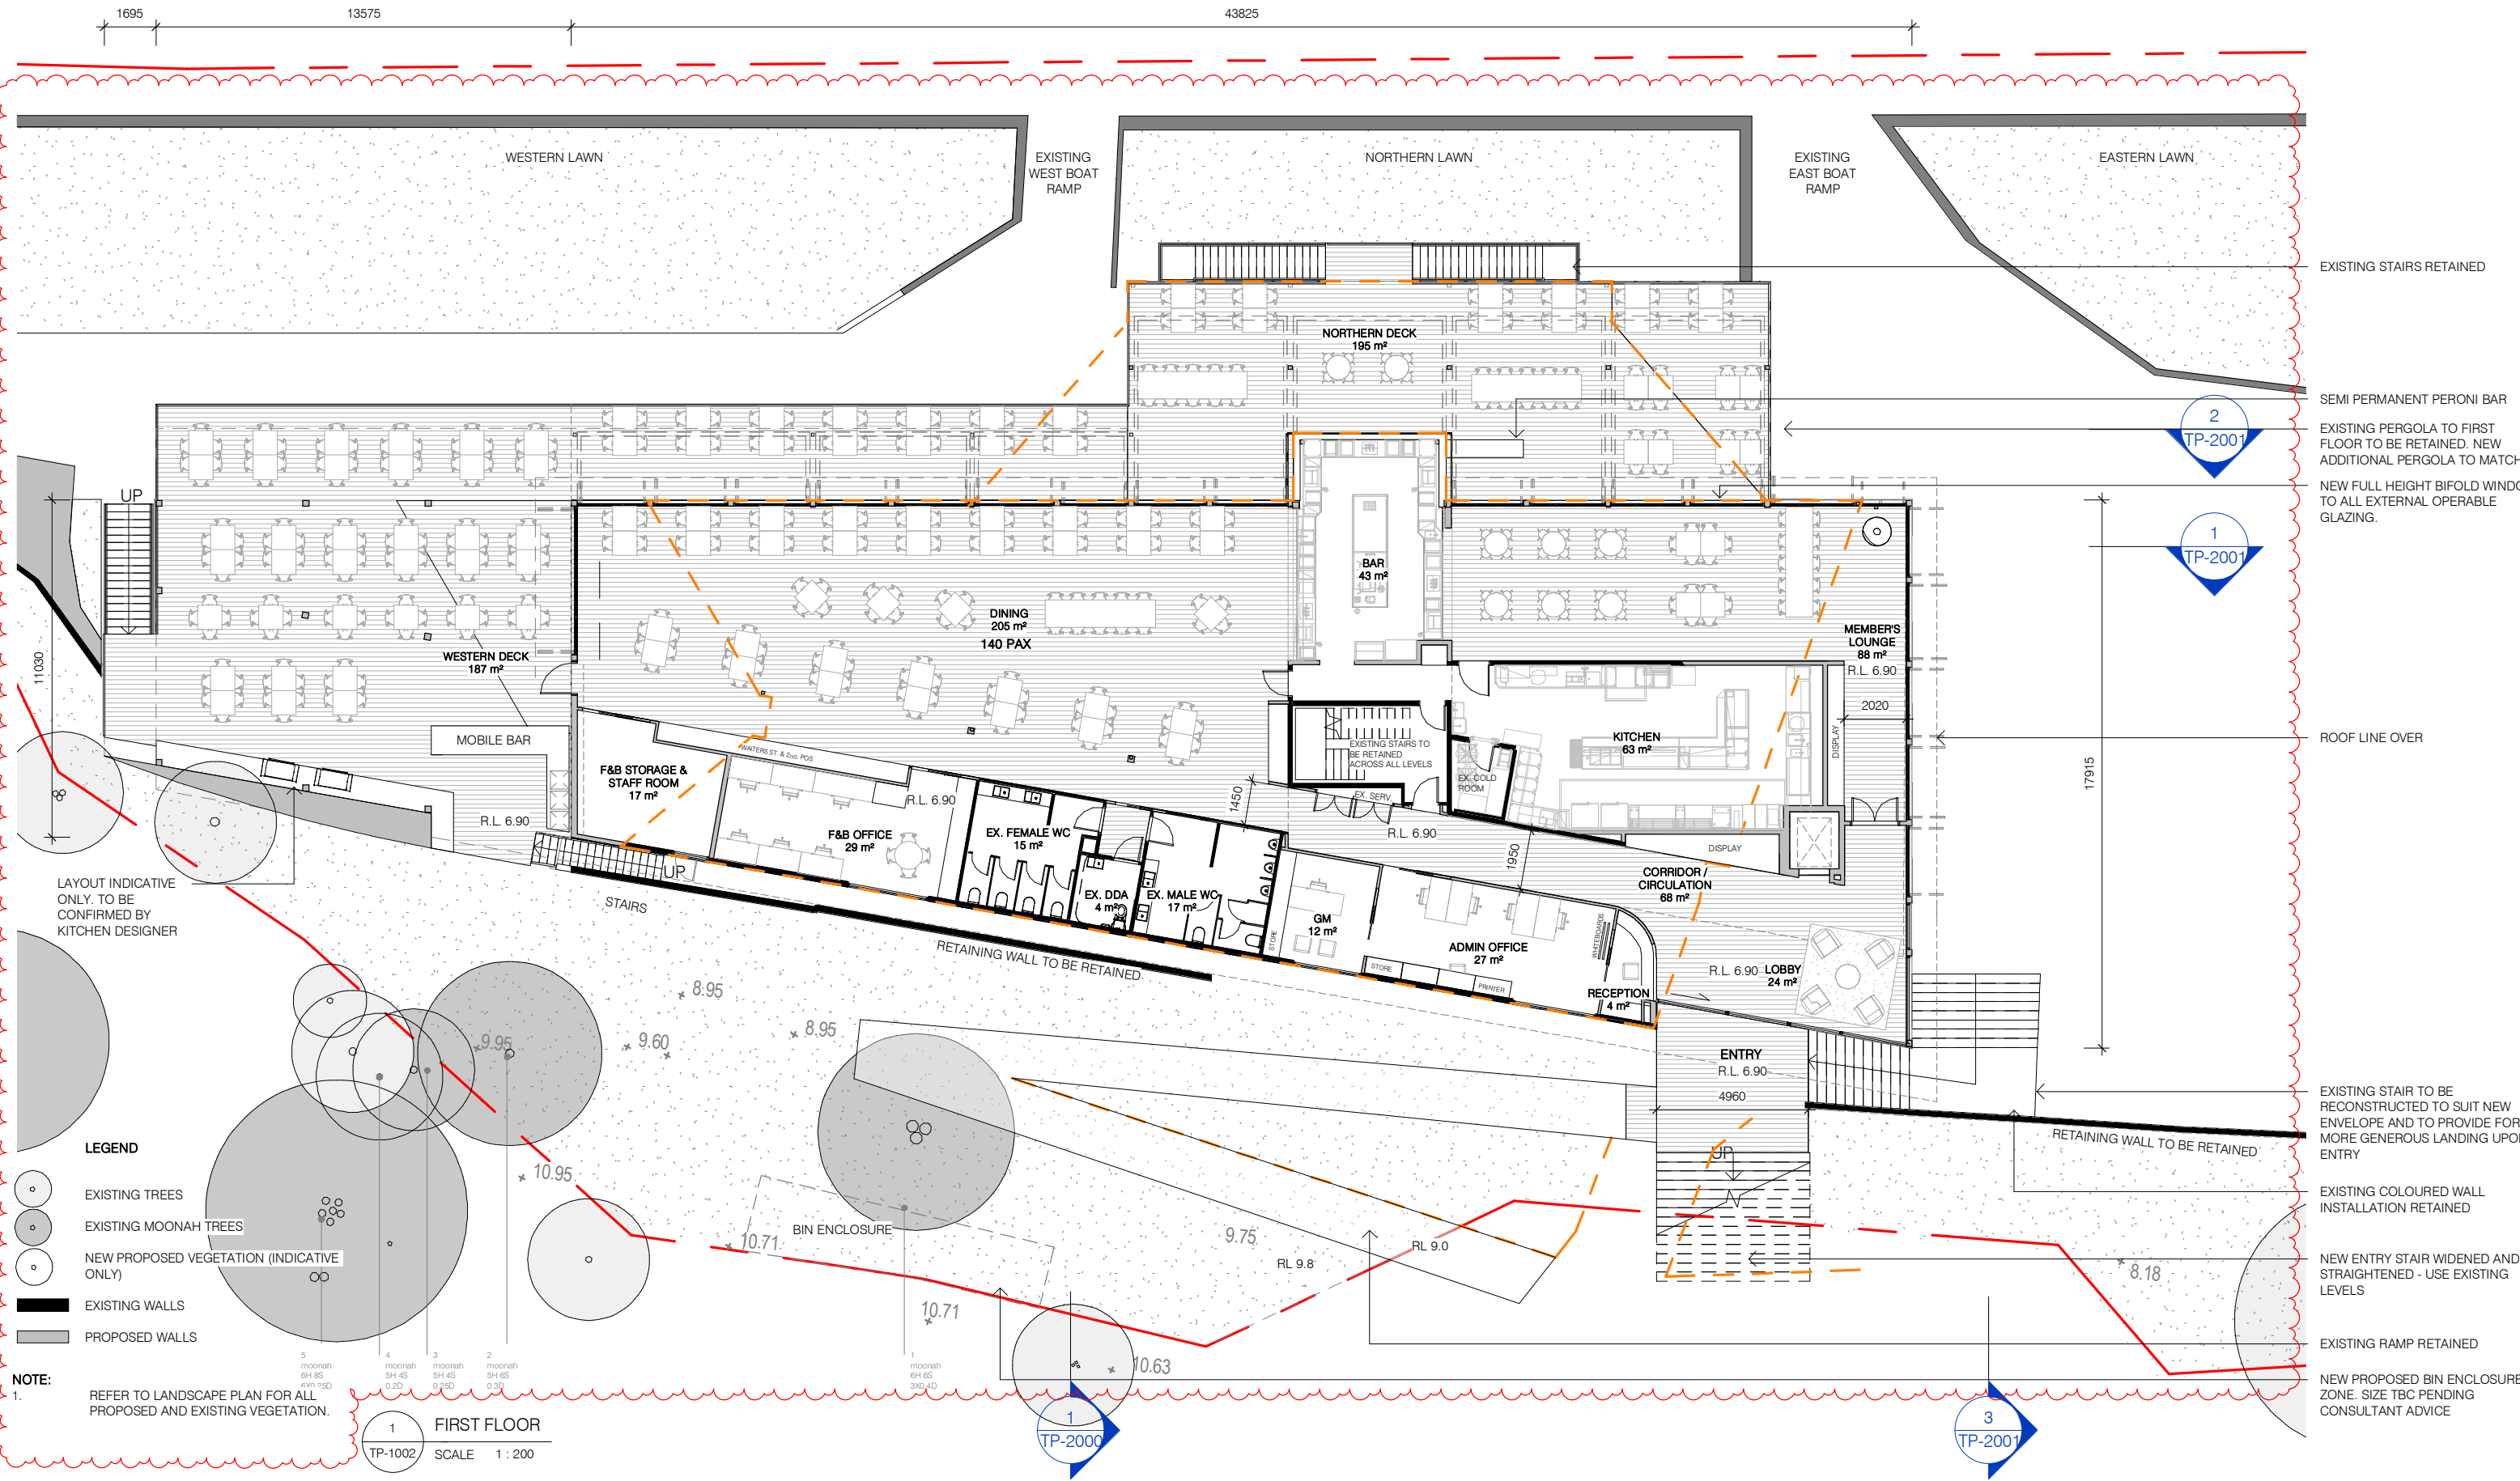


Builders / Contractors shall verify all dimensions before any work commences. Dimensions shown are nominal. Figured dimensions shall take precedence over scaled dimensions. Any discrepancies are to be made known to the Architects / Designers office prior to any works commencing on site. All shop drawings shall be submitted for review and manufacture shall not commence prior to the return of stamped shop drawings.
© Carr Interiors Pty Ltd
© Carr Architecture Pty Ltd



Rev	Date	Chkd	Issue	Project	Sorrento Sailing Couta Boat Club	Project No	18014
A	16.01.2019		For Town Planning				
B	01.05.2020		S72 Amendment				
				Title	PROPOSED FIRST FLOOR PLAN		
				Scale @A3	As indicated	Date	04/11/18
				Drawn By	JG, SM, TK	Dwg No	TP-1002
				Chkd By	Checker	Rev	B


Carr Interiors Pty Ltd
ABN 56 126 212 575
Carr Architecture Pty Ltd
ABN 47 099 953 205
Directors Sue Carr
Chris McCue ARBV AIA
Level 4 31 Flinders Lane
Melbourne VIC 3000 Australia
PO Box 18069
Collins Street East
Melbourne VIC 8003 Australia
Telephone 61 3 9665 2300
Facsimile 61 3 9650 5002
Email melb@carr.net.au
www.carr.net.au

carr

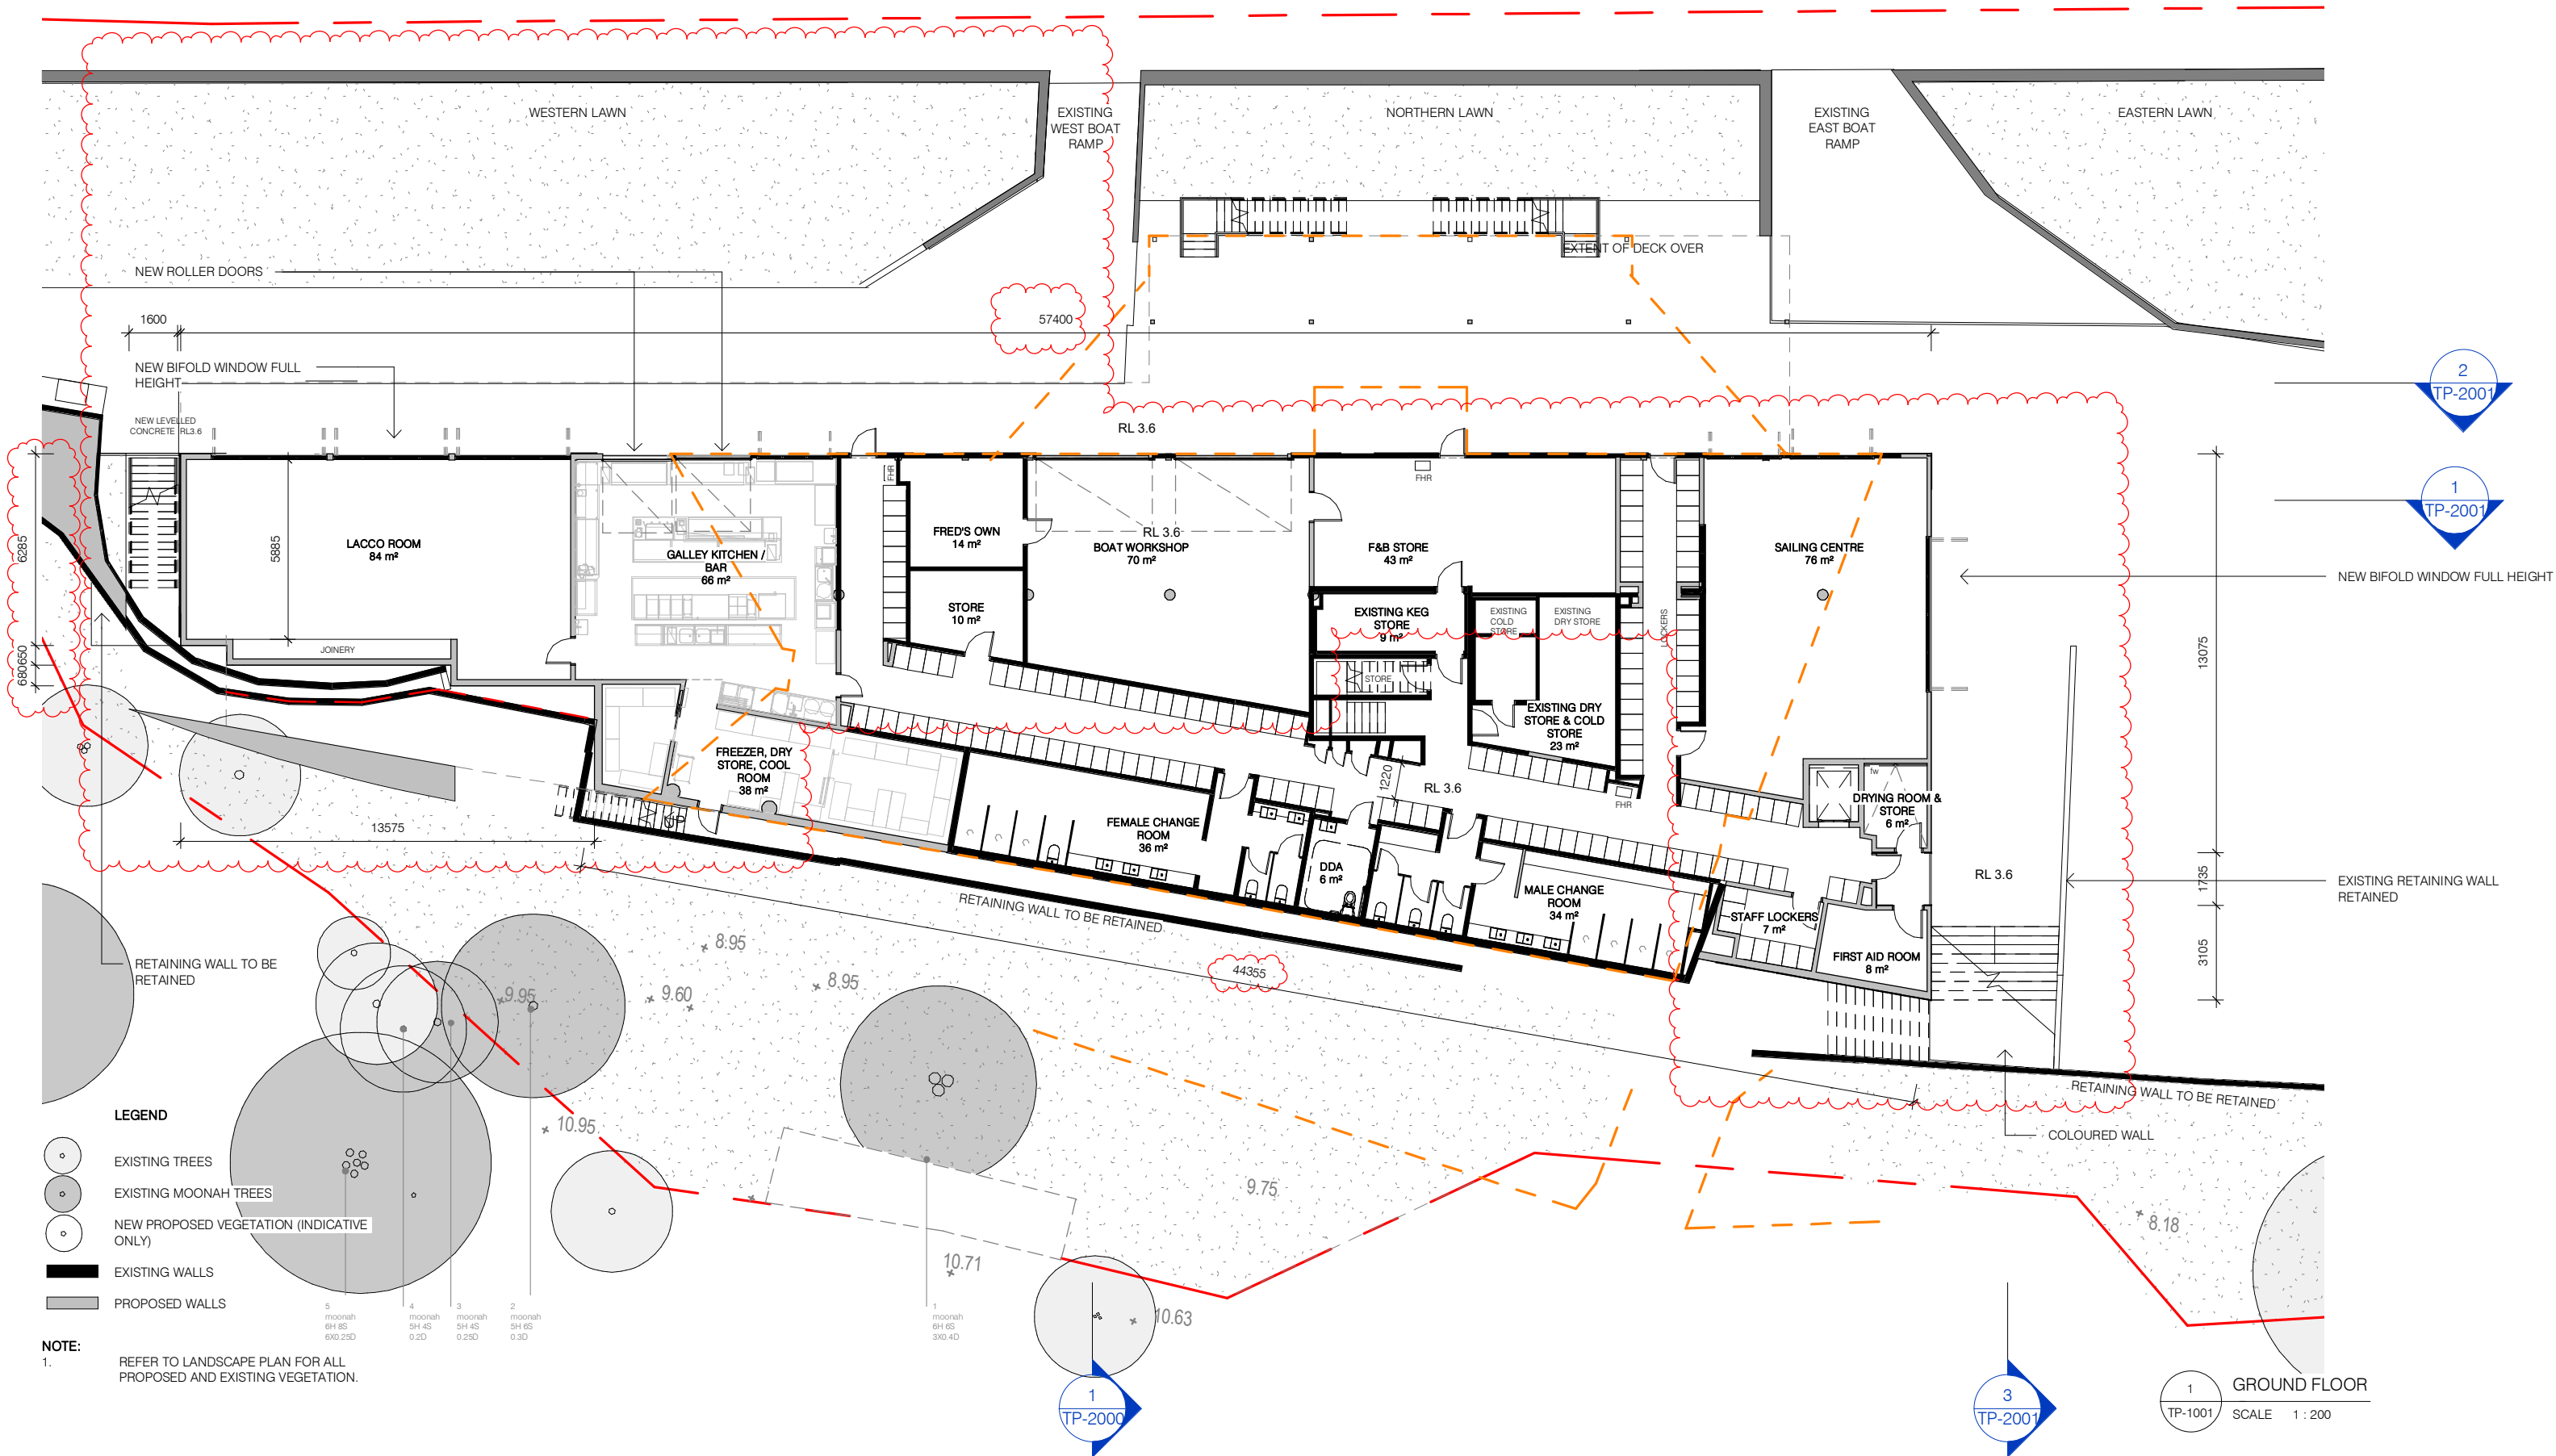

Builders / Contractors shall verify all dimensions before any work commences. Dimensions shown are nominal. Figured dimensions shall take precedence over scaled dimensions. Any discrepancies are to be made known to the Architects / Designers office prior to any works commencing on site. All shop drawings shall be submitted for review and manufacture shall not commence prior to the return of stamped shop drawings.
© Carr Interiors Pty Ltd
© Carr Architecture Pty Ltd

FOR REVIEW

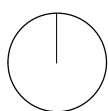

0 2 4 10m

NORTH

SCALE 1:200

Rev	Date	Chkd	Issue
A	16.01.2019		For Town Planning
B	01.05.2020		S72 Amendment

Project SORRENTO SAILING COUTA BOAT CLUB

Project No 18014

3154 POINT NEAPEAN ROAD SORRENTO

Title PROPOSED GROUND FLOOR PLAN

Scale @A3 As indicated

Date 04/11/18

Dwg No TP-1001


Drawn By JG, SM, TK

Chkd By Checker


Rev B

Carr Interiors Pty Ltd
ABN 56 126 212 575
Carr Architecture Pty Ltd
ABN 47 099 953 205
Directors Sue Carr
Chris McCue ARBV AIA
Level 4 31 Flinders Lane
Melbourne VIC 3000 Australia
PO Box 18069
Collins Street East
Melbourne VIC 8003 Australia
Telephone 61 3 9665 2300
Facsimile 61 3 9650 5002
Email melb@carr.net.au
www.carr.net.au

carr

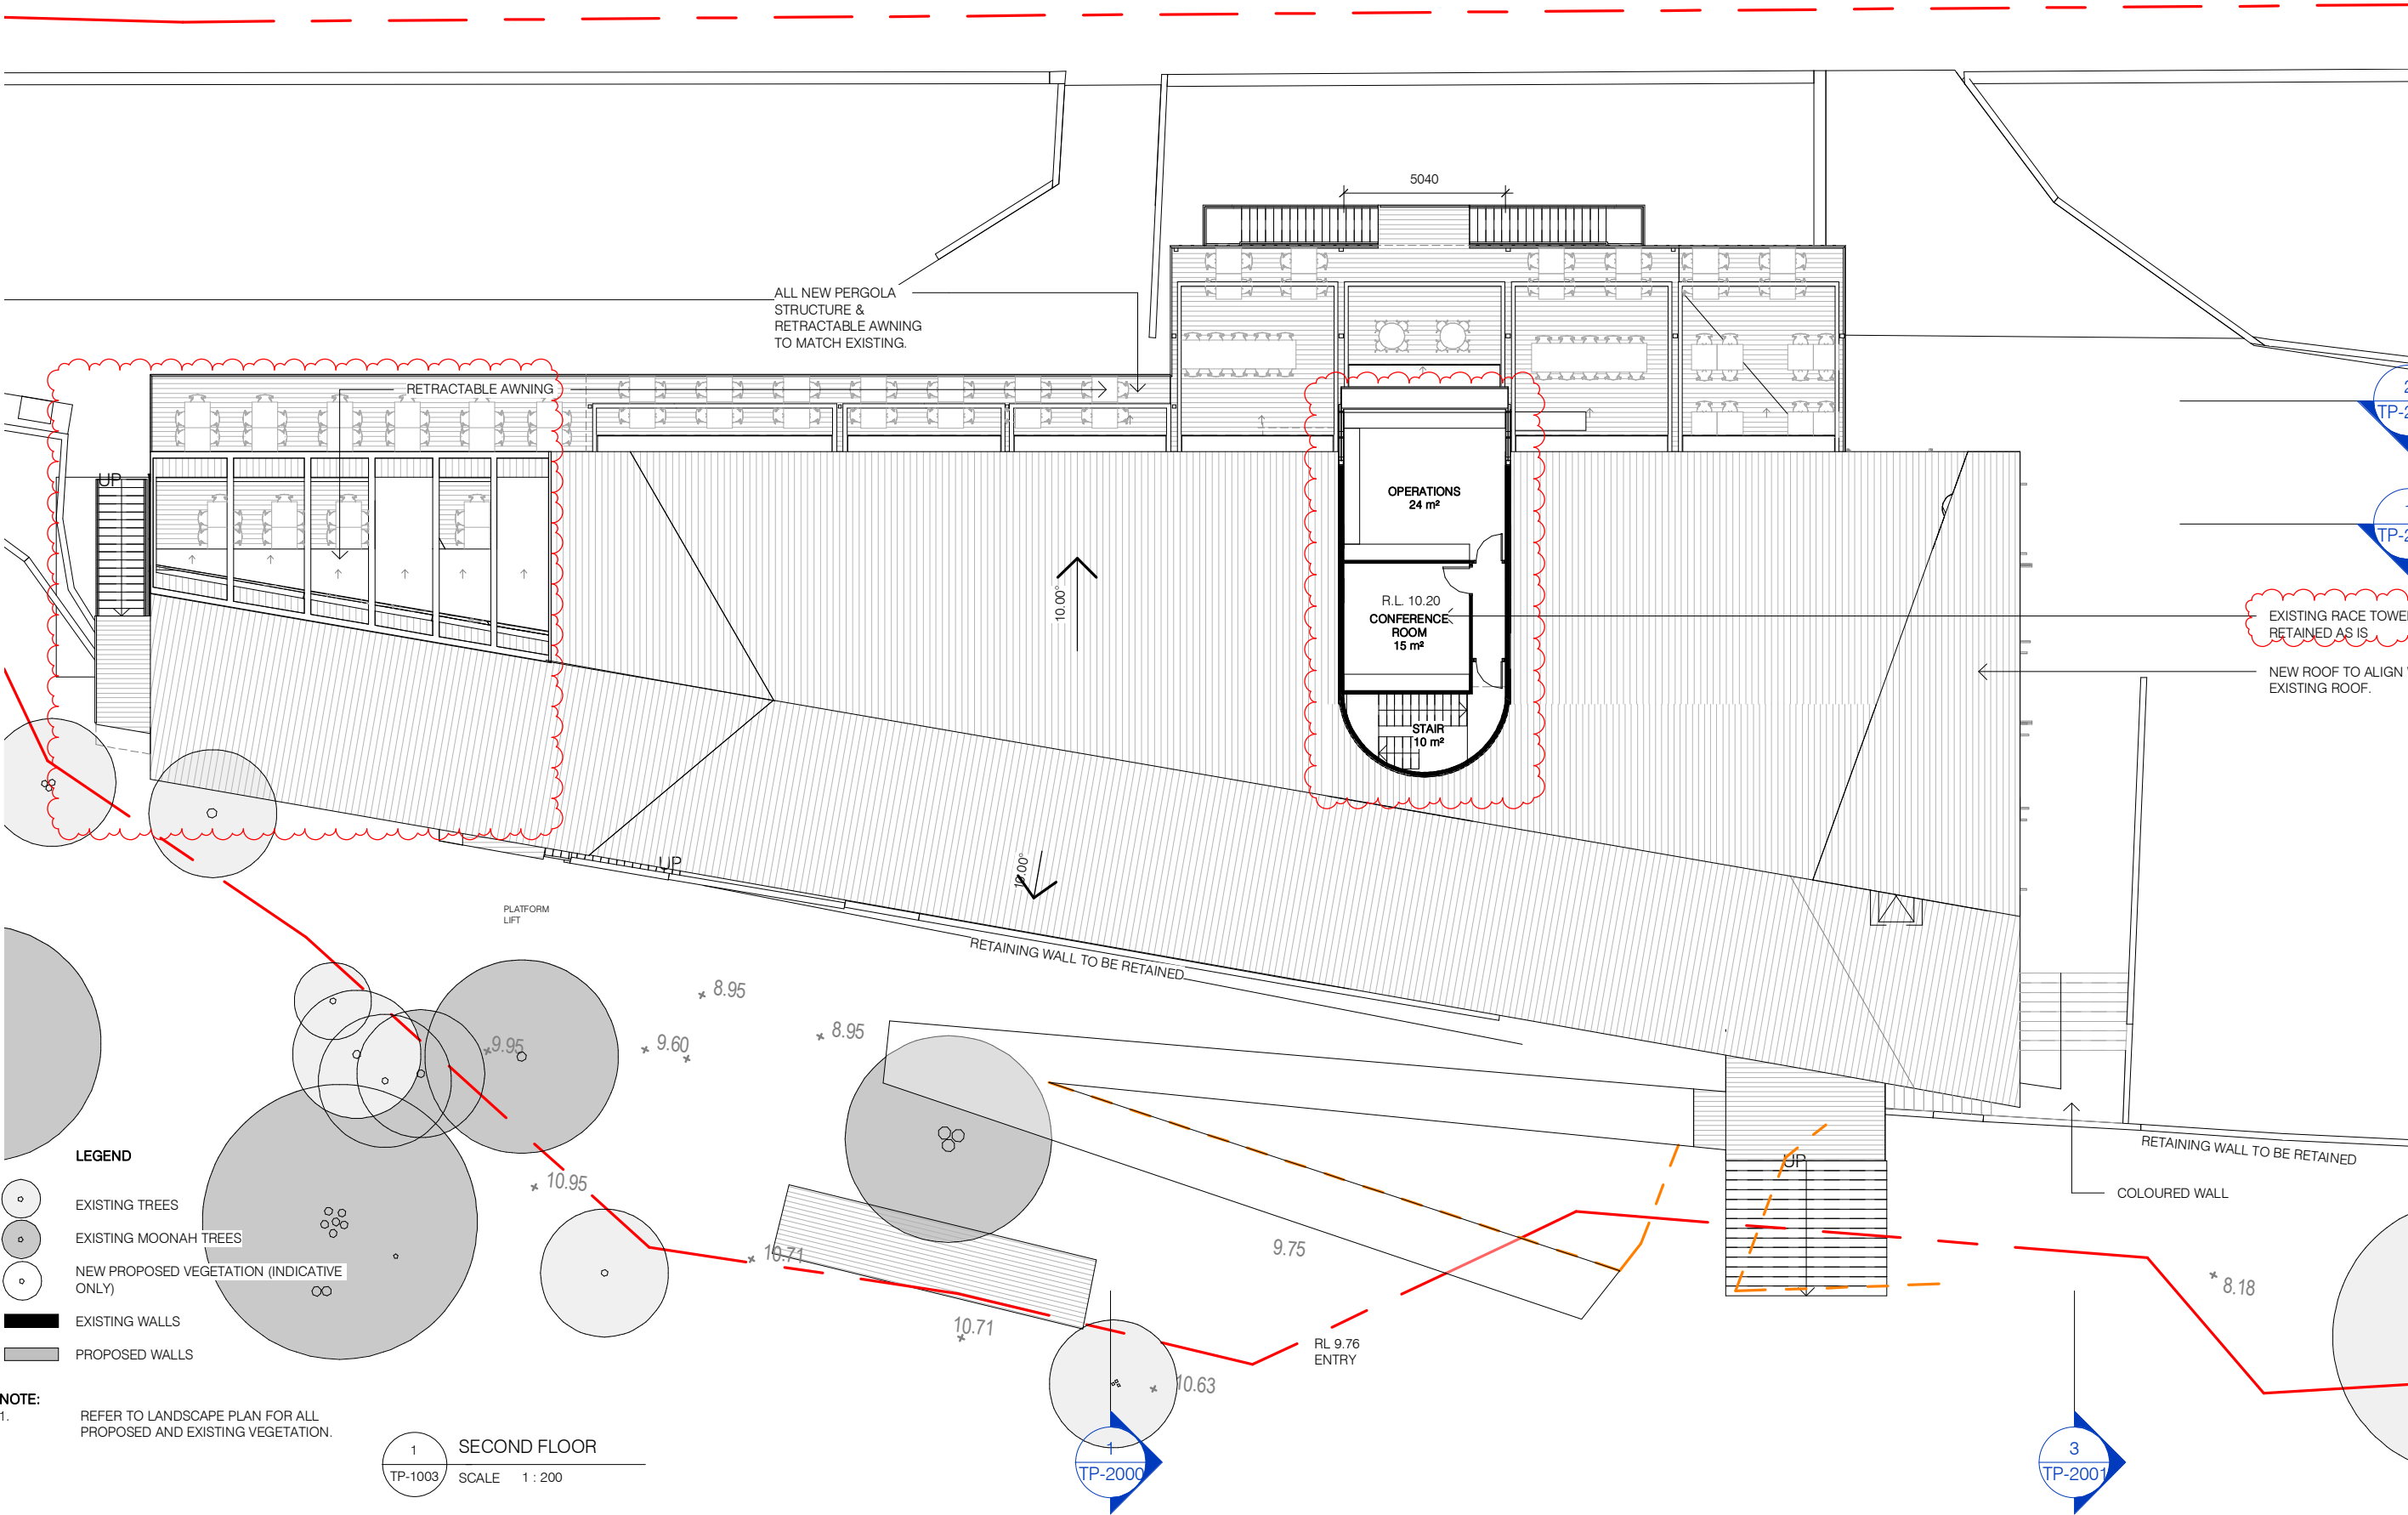

FOR REVIEW

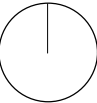

0 2 4 10m
SCALE 1:200

Rev	Date	Chkd	Issue
A	16.01.2019		For Town Planning
B	01.05.2020		S72 Amendment

Project SORRENTO SAILING COUTA BOAT CLUB
3154 POINT NEAPEAN ROAD SORRENTO

Project No 18014

Title PROPOSED SECOND FLOOR PLAN

Scale @A3	As indicated	Date	04/11/18	Dwg No	TP-1003
Drawn By	JG, SM, TK	Chkd By	Checker	Rev	B

Carr Interiors Pty Ltd
ABN 56 126 212 575
Carr Architecture Pty Ltd
ABN 47 099 953 205
Directors Sue Carr
Chris McCue ARBV AIA
Level 4 31 Flinders Lane
Melbourne VIC 3000 Australia
PO Box 18069
Collins Street East
Melbourne VIC 8003 Australia
Telephone 61 3 9665 2300
Facsimile 61 3 9650 5002
Email melb@carr.net.au
www.carr.net.au

carr